


HOUSE DETAIL SCALE 1" = 30'

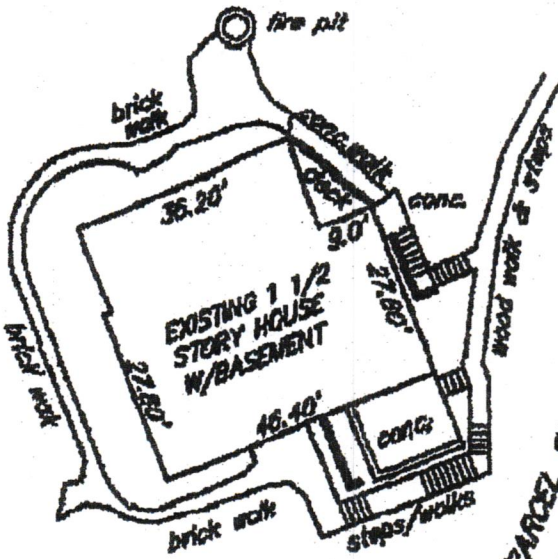

- = Trenching to feed wires
30 L.F. of Temp Disturbance
- = Under existing walkway

RECORD PLAT NORTH



APPROVED
AS NOTED IN RED

MAY 29 2014

Andrew Chmura

CRITICAL AREA REVIEW
ST. MARY'S COUNTY
LAND USE AND GROWTH MANAGEMENT


SURVEYOR'S CERTIFICATE

I hereby certify that the position of all the existing improvements on the above described property has been carefully established by a Transit-Type Survey and that, subject to a title search and unless otherwise shown hereon, there are no encroachments.

NOTES:

1. Unless otherwise shown hereon, Lot Corners have not been set with this Improvement Location Survey.
2. This plat is of benefit to a consumer only insofar as it is required by a lender or a title insurance company or its agent in connection with contemplated transfer or financing.
3. This plat is not to be relied upon for the establishment of location of fences, porches, buildings, or other existing or future improvements.
4. This plat does not represent a Boundary Survey by this firm as such may not be required for the transfer of title or

PATUXENT RIVER

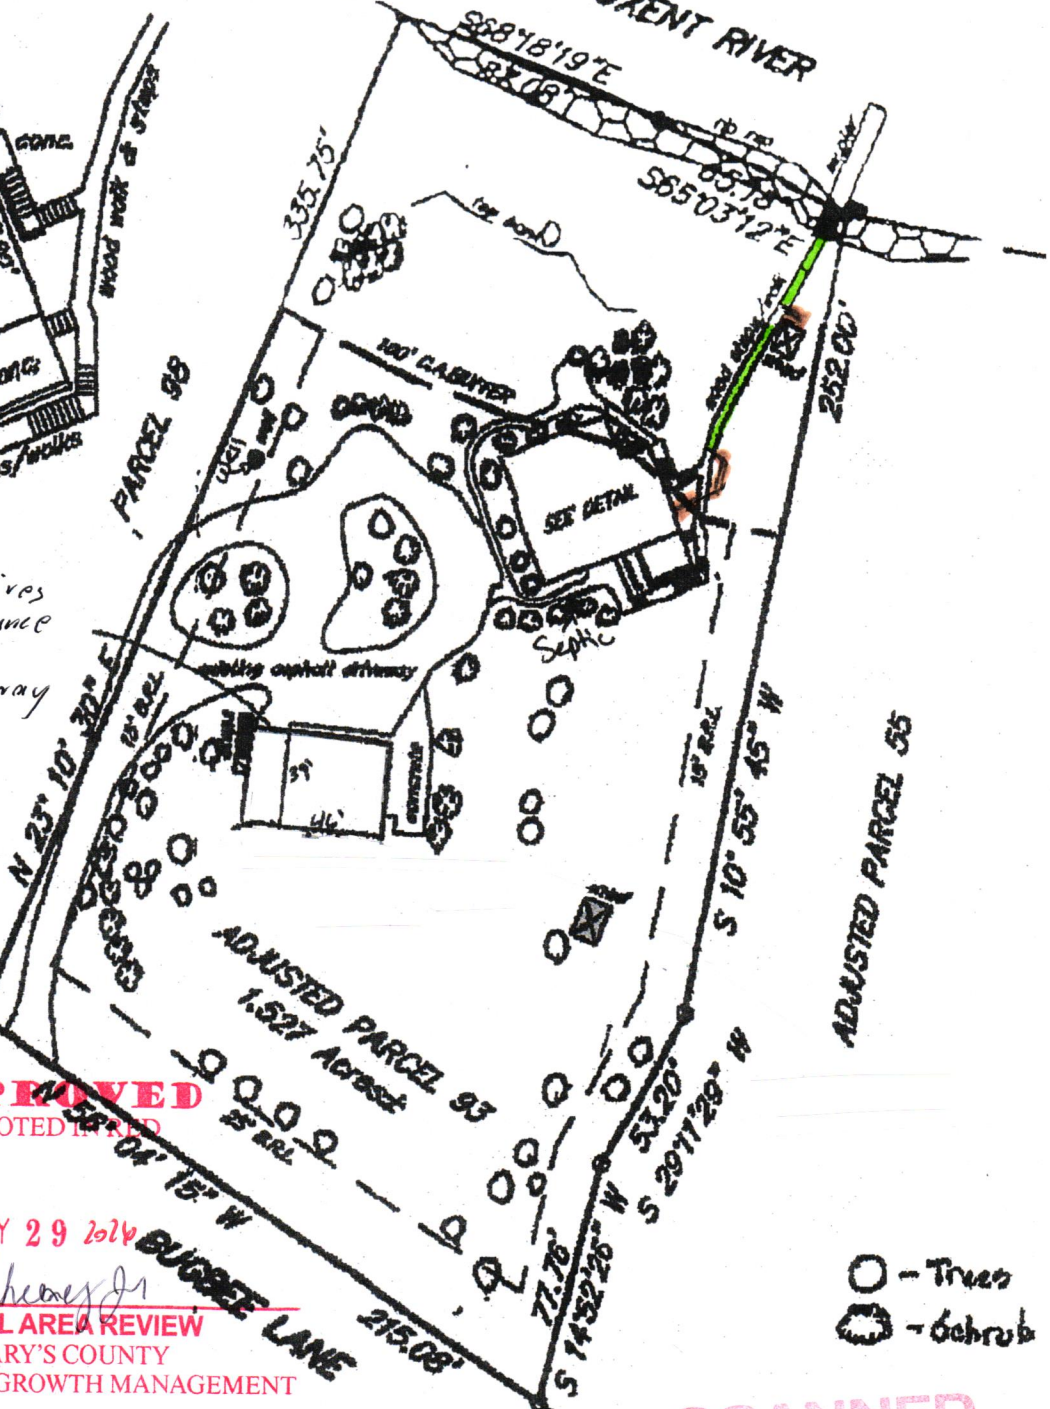

- - Trees
- - Shrub

SCANNED

